


GENERAL NOTES:

- A. PIPING SHOWN ON THIS DRAWING IS BASED ON RECORD DRAWINGS AND CONDITIONS VIEWED DURING FIELD INVESTIGATIONS. THE P.C. SHALL CONFIRM EXISTING PIPING AND SIZES, NOTIFY THE ENGINEER AND ARCHITECT OF SIGNIFICANT DISCREPANCIES PRIOR TO COMMENCEMENT OF WORK.
- B. EXISTING BRANCH PIPING WILL BE MODIFIED AS REQUIRED TO MAINTAIN OPERATION OF PLUMBING FIXTURES TO REMAIN.


REMOVAL NOTES:

- 1 4" SAN, 3" V, 2 1/2" C, 1/4" H AND (2) 3/4" HWR RISERS (S-32) TO REMAIN.
- 2 4 SAN, 2 1/2" V, 2 1/2" C, 1/4" H AND 3/4" HWR RISERS (S-32A) TO REMAIN.
- 3 4" SAN, 4" V, 2" C, 1" H AND (2) 3/4" HWR RISERS (S-37) TO REMAIN.
- 4 4" SAN, 4" V, 2" C AND (2) 3/4" HWR RISERS (S-39) TO REMAIN.
- 5 4" SAN, 4" V, 2" C, 3/4" H AND (2) 3/4" HWR RISERS (S-41) TO REMAIN.
- 6 4" SAN, 3" V, 2" C, 1/4" H AND (2) 3/4" HWR RISERS (S-33) TO REMAIN.
- 7 5" SAN, 4" V, 2" C, 1" H AND (2) 3/4" HWR RISERS (S-34) TO REMAIN.
- 8 4" SAN, 4" V, 2 1/2" C, 1" H AND (2) 3/4" HWR RISERS (S-36) TO REMAIN.
- 9 4" SAN, 3" V, 2" C, 1" H AND (2) 3/4" HWR RISERS (S-38) TO REMAIN.
- 10 4" SAN, 4" V, 3/4" HWR RISER (S-40) TO REMAIN.
- 11 4" SAN, 3" V, 2" C, 1/4" H AND (2) 3/4" HWR RISERS (S-68) TO REMAIN.
- 12 4" SAN, 4" V, 2" C, 3/4" H AND (2) 3/4" HWR RISERS (S-69) TO REMAIN.
- 13 4" SAN, 3" V, 1" C, 1" H AND (2) 3/4" HWR RISERS (S-71) TO REMAIN.
- 14 4" SAN, 4" V, 3/4" HWR RISER (S-72) TO REMAIN.
- 15 DISCONNECT AND REMOVE SINK IN ITS ENTIRETY. REMOVE 1/2" VENT AND 1/2" H&C WATER PIPING BACK TO RISERS AND CAP. TURN SINK OVER TO OWNER FOR SALVAGE.
- 16 DISCONNECT AND REMOVE LAVATORY IN ITS ENTIRETY. REMOVE 1/2" V AND 1/2" H&C PIPING BACK TO RISERS AND CAP.
- 17 DISCONNECT AND REMOVE SHOWER IN ITS ENTIRETY. REMOVE 2" V AND 1/2" H&C PIPING BACK TO RISERS AND CAP.
- 18 DISCONNECT AND REMOVE WATER CLOSET IN ITS ENTIRETY. REMOVE 2" V AND 1" C PIPING BACK TO RISERS AND CAP.
- 19 DISCONNECT AND REMOVE ELECTRIC WATER COOLER IN ITS ENTIRETY. REMOVE 1/2" V AND 1/2" C PIPING BACK TO RISERS AND CAP.
- 20 DISCONNECT AND REMOVE V PIPING, SIZE AS INDICATED BACK TO RISER AND CAP.
- 21 DISCONNECT AND REMOVE 2" V PIPING DOWN IN ITS ENTIRETY.
- 22 DISCONNECT AND REMOVE 3/4" AND 1/2" DRAIN AND 3/4" C PIPING DOWN IN THEIR ENTIRETY.
- 23 DISCONNECT AND REMOVE 3/4" C AND (2) 1/2" DRAIN PIPING TO HVAC UNIT IN ITS ENTIRETY. REMOVE PIPING BACK TO RISER AND CAP.
- 24 DISCONNECT AND REMOVE FLOOR DRAIN IN ITS ENTIRETY. P.C. TO CUT FLOOR AS REQUIRED FOR COMPLETE FLOOR DRAIN REMOVAL. P.C. SHALL PATCH FLOOR TO MATCH EXISTING CONDITIONS. COORDINATE PATCHING OF FLOOR WITH THE G.C.

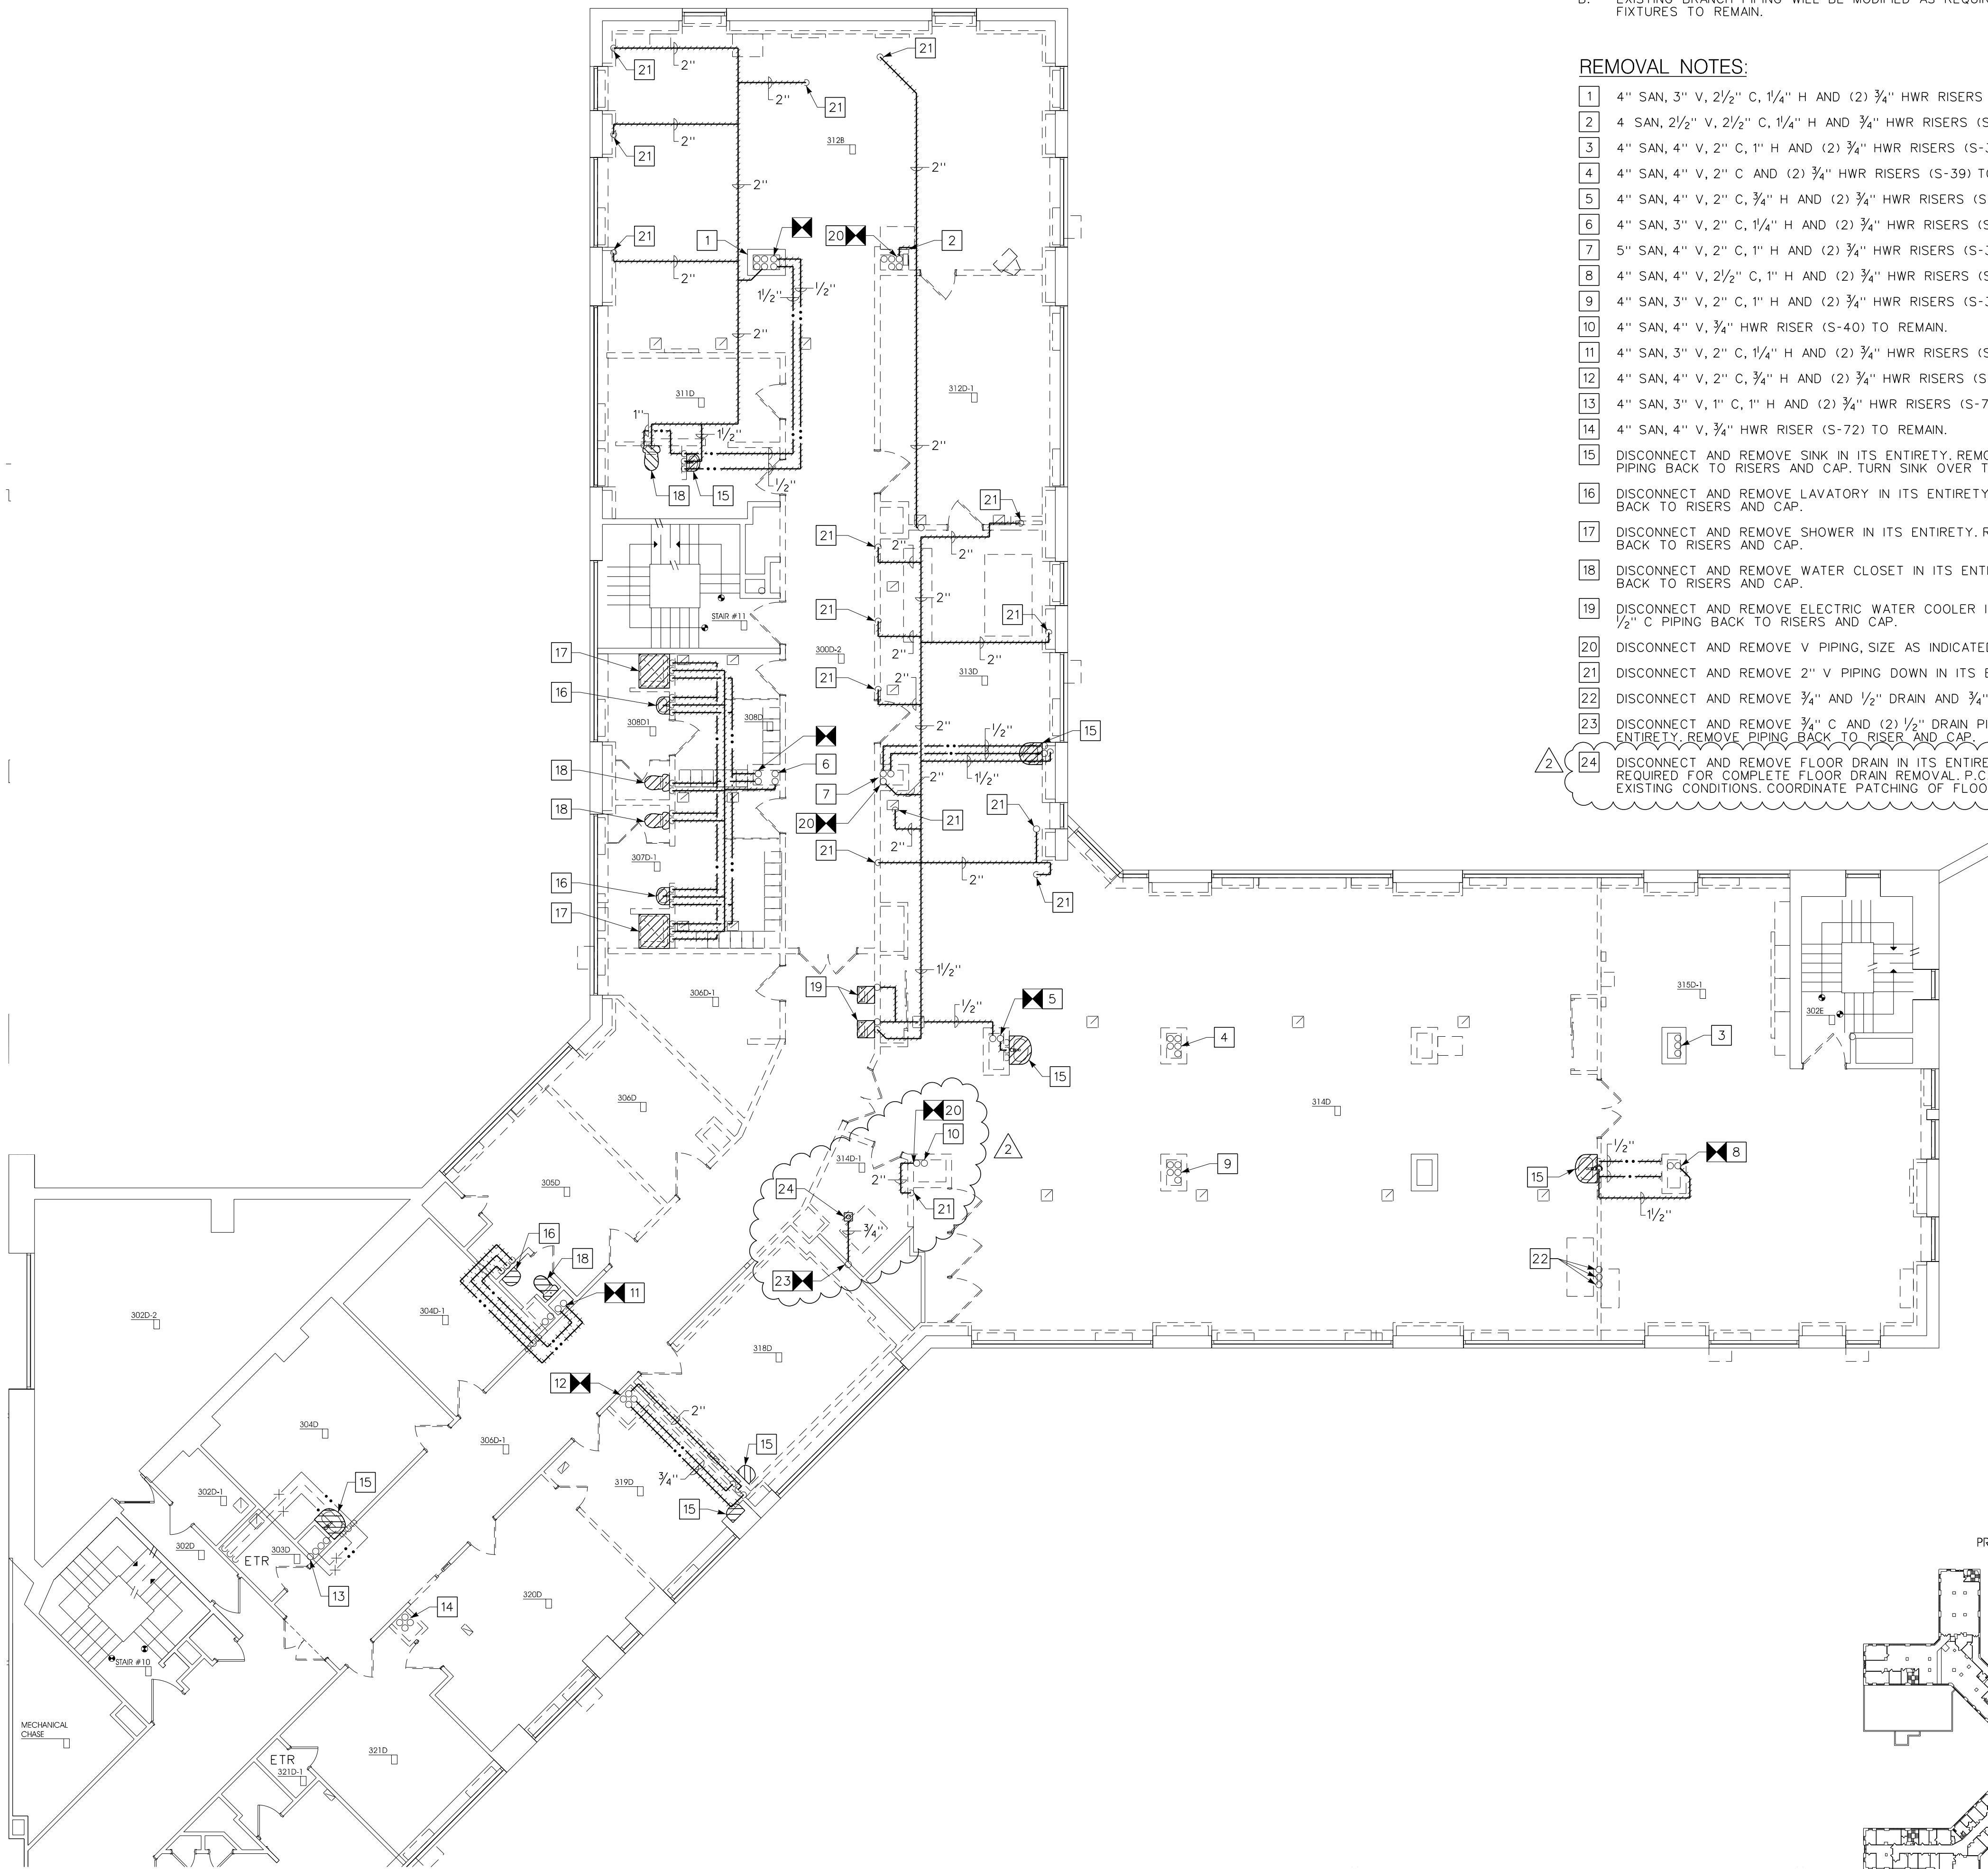

PARTIAL THIRD FLOOR PLAN - PLUMBING REMOVALS

1/8" = 1'-0"

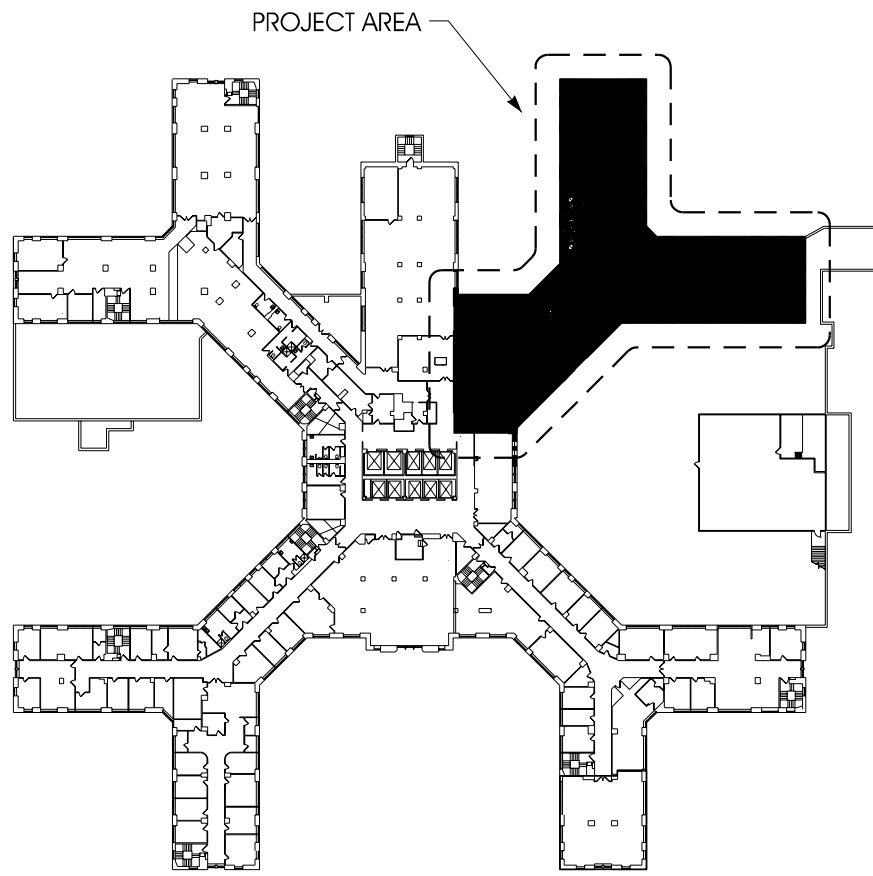

KEYPLAN

NO SCALE

REVISIONS:	DATE:
#01 - ISSUED FOR BIDDING	07.MAR.2012
#02 - ADDENDUM #1	06.APR.2012

VA WESTERN NEW YORK HEALTHCARE
SYSTEM
3495 BAILEY AVENUE
BUFFALO, NY 14202



tmm
architect
TMM ARCHITECTURE, DESIGN & PLANNING,
P.C.
148 DELAWARE AVE.
BUFFALO, NY 14202
P: 716.883.3516 F: 716.883.4740
CONTACTS:
JEFFREY J. MARCONI, AIA (ASSOCIATE)
JEFFREY J. MARCONI, AIA (PROJECT MANAGER)
JEFFREY J. MARCONI, AIA (PROJECT MANAGER)
JEFFREY J. MARCONI, AIA (PROJECT MANAGER)

SEINNA ENVIRONMENTAL TECHNOLOGIES, LLC
1650 ELMWOOD AVE.
BUFFALO, NY 14222-2204
P: 716.332.3134
CONTACTS:
JOHN PINEY
JOHN PINEY (PROJECT MANAGER)
JOHN PINEY (PROJECT MANAGER)
JOHN PINEY (PROJECT MANAGER)

IBC ENGINEERING
2495 MONROE ST. # 318
BUFFALO, NY 14214-2192
P: 716.836.2319 F: 716.836.2319
CONTACTS:
JOSEPH W. MEE (PROJECT MANAGER)
JOSEPH W. MEE (PROJECT MANAGER)
JOSEPH W. MEE (PROJECT MANAGER)

ARCHITECT & CONSULTANTS:

STAMP

CARDIOLOGY MANAGER	DATE	ENGINEERING MANAGER	DATE
INFECTION CONTROL	DATE	CARELINE MANAGER	DATE
SAFETY OFFICER	DATE	CHIEF OF STAFF	DATE

Drawing Title: PARTIAL THIRD FLOOR PLAN - PLUMBING REMOVALS	
MEDICAL CENTER DIRECTOR	DATE
ASSOCIATE MEDICAL CENTER DIRECTOR	DATE

Project Title: VAMC PHYSICAL THERAPY RENOVATIONS	
Building Number: 1	Checked: DDR
Location: V.A.M.C. BUFFALO, NEW YORK	Drawn: KGP

Date: 14.JAN.2011
Station Number: 528
Sheet: 10-107-PD101

